

SUITE 1300 AB - 8,014 RSF

SUITE AS-BUILT PLAN



09.21.2022



50 SOUTH SIXTH

a mapletree property

Minneapolis, Minnesota

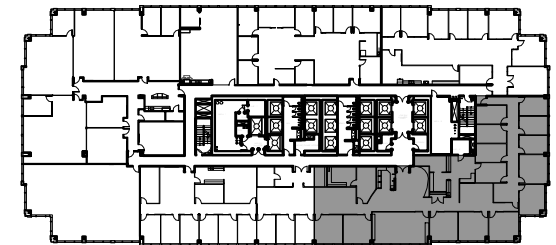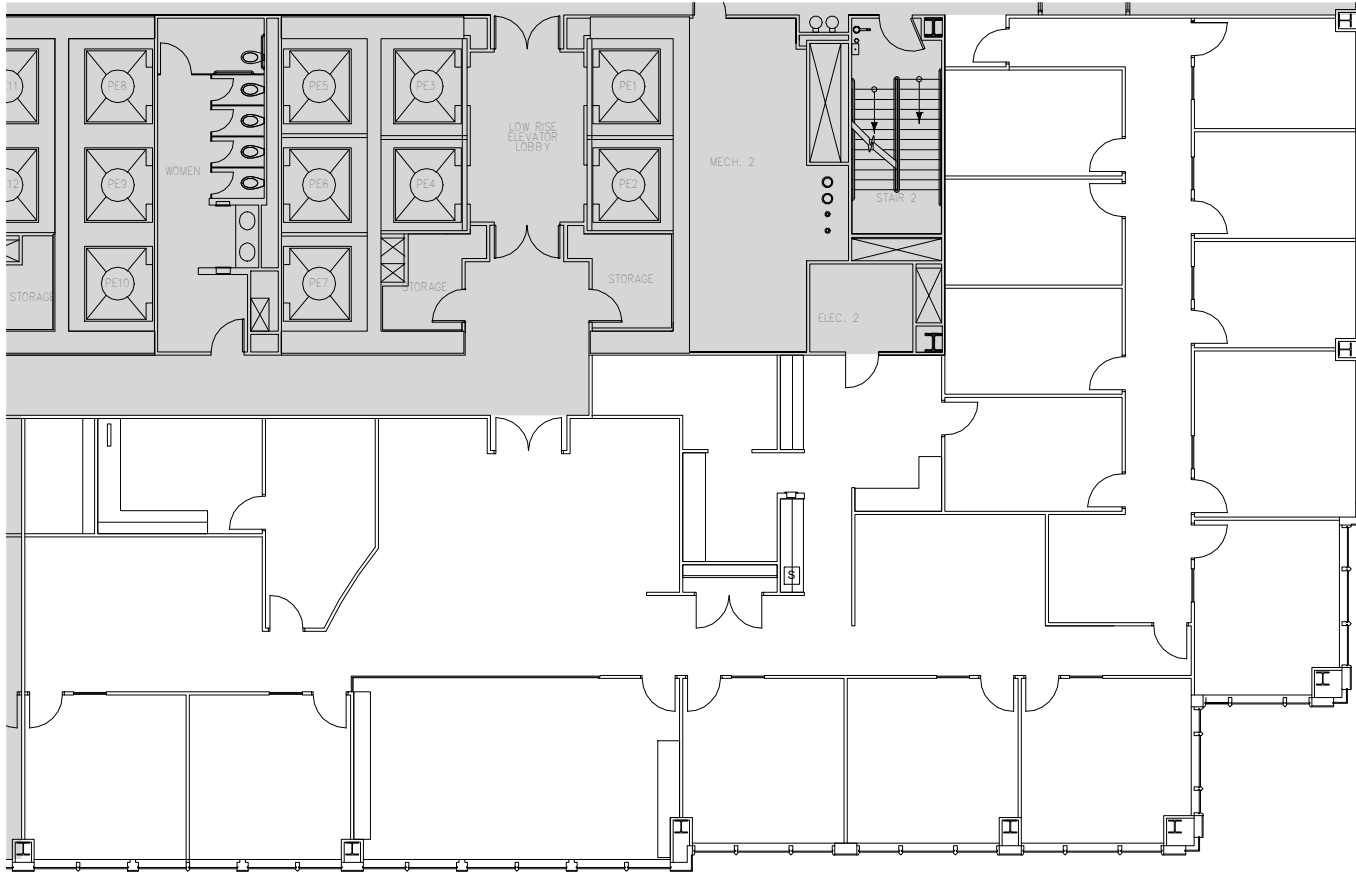

KEY PLAN: 13th FLOOR

Owned by:
mapletree

Leased by:
NEWMARK

Mary Burnton
612.430.9968
mary.burnton@nrmk.com

Brent Erickson
612.430.9970
brent.erickson@nrmk.com

Callie Ronkowski
612.430.9975
callie.ronkowski@nrmk.com

SCALE: NTS
NELSON

